



# COMMONWEALTH of VIRGINIA

DEPARTMENT OF TRANSPORTATION  
1401 EAST BROAD STREET  
RICHMOND, VIRGINIA 23219 2000

Gregory A. Whirley  
Commissioner

July 29, 2013

## MEMORANDUM

To: All Holders of the Virginia Department of Transportation's 2008 Road and Bridge Standards

The following is a list of sheets contained in the 2008 Road and Bridge Standards that have been revised. Please add these pages to your copy of the standards. An interim standard sheet will not be required in plan assemblies for the following sheets only. Changes to these sheets will not affect the basis of payment or estimates.

<u>PAGE</u>	<u>REVISION</u>
300.01	Revised index voiding page 303.01 Standard WP-1
303.01	Void - Standard WP-1 Method of Widening Bridge Approach Pavement
503.02	Corrected center detail for Metal Post to show the 6" dimension from the top of post to the top of the fence.

The following is a list of revised standards to the 2008 Road and Bridge Standards that *require* an interim standard sheet to be included in your plan assembly until the next edition of the standards is published. Please add these pages to your copy of the standards. The respective interim standard sheet number has been placed with the revised standard. The interim standard sheets are available on VDOT's web site, on the FTP server, and in Falcon DMS for VDOT personnel. These interim standard sheets will be required in plan assemblies for Tier 1 projects advertised November 26, 2013 (Non Federally Eligible), December 10, 2013 (Federally Eligible) and later, along with Tier 2 projects advertised March 11, 2014 and later.

<u>PAGE</u>	<u>INTERIM</u>	<u>STANDARD</u>	<u>REVISION</u>
201.08	IIS02_06	MC-4	CLARIFIED THE SECTION DETAIL TO SHOW THE DIFFERENCE IN THE PAVED SHOULDER DEPTH AND THE PAVING UNDER GUARDRAIL DEPTH


<u>PAGE</u>	<u>INTERIM</u>	<u>STANDARD</u>	<u>REVISION</u>
304.02	IIS03_04	RS-3	REVISED NOTE 7 REMOVED STATEMENT " <i>IN ASPHALT CONCRETE PAVEMENT THAT IS BEEN IN PLACE MORE THAN ONE YEAR</i> ".
304.03	IIS03_05	RS-4	REVISED NOTE 4 REMOVED STATEMENT " <i>IN ASPHALT CONCRETE PAVEMENT THAT IS BEEN IN PLACE MORE THAN ONE YEAR</i> ".
502.01	IIS05_18	MB-3	REVISED FLARE RATE TABLE TO MATCH THE RDM AND AASHTO
1005.10	1005.10	BCQ-10	UPDATED SHEET TO SHOW WINGWALL DESIGNATIONS
1324.10	IIS13_04	OSS-1	THE ELEVATION DRAWINGS WERE UPDATED INCREASING THE PROJECTION ABOVE GRADE FOR FOUNDATIONS AND NOTE 7 AND 8 WERE ADDED
1324.13	IIS13_41	OSS-1	FOOTING DETAIL UPDATED INCREASING THE PROJECTION ABOVE GRADE FOR FOUNDATIONS

If you have any questions or comments regarding this revision, please contact Chuck Patterson P.E., at (804) 786-1805, of the Standards and Special Design Section.

Sincerely,

Signature on file: July 29, 2013

B. A. Thrasher, P.E.  
State Location & Design Engineer

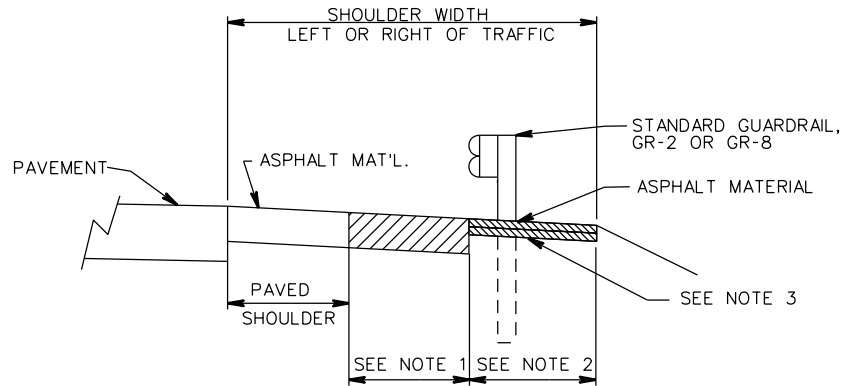


**ASPHALT PAVING UNDER GUARDRAIL**

(FOR USE WHERE ASPHALT CURB IS NOT REQUIRED)


**NOTES:**

1. TO BE CONSTRUCTED WITH THE SAME MATERIAL AND TO THE SAME DEPTH AS THE ROADWAY PAVED SHOULDER.
2. TO BE CONSTRUCTED WITH THE SAME ASPHALT MATERIALS AS THE PAVED SHOULDER TO THE FOLLOWING DEPTHS:  

ALLOWABLE DEPTHS OF ASPHALT MATERIAL	
IM-19.0A OR IM-19.0D	2" MIN
BM-25.0	3" MIN
3. DEPTH OF ASPHALT MATERIAL MAY BE EXTENDED AT THE CONTRACTOR'S OPTION TO COINCIDE WITH THE BOTTOM OF THE PAVED SHOULDER COURSE AT NO INCREASE IN THE QUANTITY OF ASPHALT MATERIAL COMPUTED USING THE ABOVE SPECIFIED DEPTH.
4. ADDITIONAL 5 FEET ASPHALT PAVING BEYOND POINT WHERE GUARDRAIL CROSSES SHOULDER LINE.
5. FOR ADDITIONAL DESIGN AND PLACEMENT INFORMATION SEE SHEET 1 OF 2.

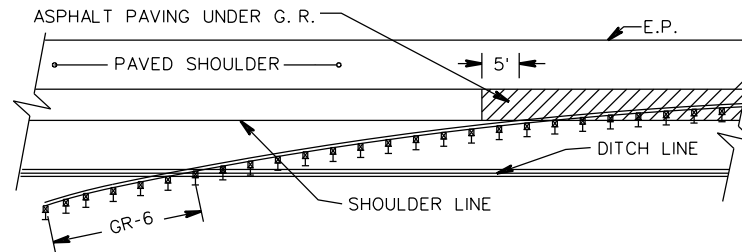

**GR-6 TERMINAL**

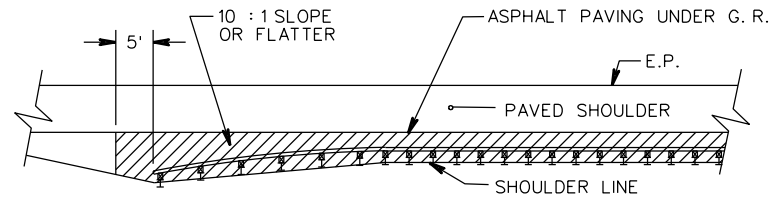

**GR-7 & GR-9 TERMINALS**

METHODS FOR BEGINNING & ENDING ASPHALT PAVING UNDER GUARDRAIL AND GUARDRAIL INSTALLATION SITE PREPARATION REQUIREMENTS FOR GR-7 AND GR-9 SEE STANDARD.



ROAD AND BRIDGE STANDARDS

SHEET 2 OF 2

REVISION DATE

201.08

7/13

**ASPHALT CURB AND GUTTER  
(ASPHALT PAVING UNDER GUARDRAIL)**

VIRGINIA DEPARTMENT OF TRANSPORTATION

SPECIFICATION REFERENCE

105  
502

STANDARD	TITLE	PAGE
PR-2	PLAIN AND REINFORCED CONCRETE PAVEMENT SHOWING REINFORCEMENT, LONGITUDINAL AND TRANSVERSE JOINTS	301.01
	PLAIN AND REINFORCED CONCRETE PAVEMENT SHOWING REINFORCEMENT, LONGITUDINAL AND TRANSVERSE JOINTS	301.02
	PLAIN AND REINFORCED CONCRETE PAVEMENT SHOWING REINFORCEMENT, LONGITUDINAL AND TRANSVERSE JOINTS	301.03
	STANDARD LOAD TRANSFER ASSEMBLY CONTRACTION JOINT	301.04
	STANDARD LOAD TRANSFER ASSEMBLY EXPANSION JOINT	301.05
PR-3	<del>8" CONTINUOUSLY REINFORCED CONCRETE PAVEMENT (WIRE MESH REINFORCEMENT)</del>	THIS STANDARD IS VOID <del>301.06</del>
	8" CONTINUOUSLY REINFORCED CONCRETE PAVEMENT (STEEL BAR REINFORCEMENT)	301.07
	8" CONTINUOUSLY REINFORCED CONCRETE PAVEMENT (FOR USE WITH BAR OR WIRE MESH REINFORCEMENT)	301.08
	8" CONTINUOUSLY REINFORCED CONCRETE PAVEMENT (LEAVE OUT JOINT DETAIL)	301.09
PR-4	9" CONTINUOUSLY REINFORCED CONCRETE PAVEMENT (STEEL BAR REINFORCEMENT)	301.10
	9" CONTINUOUSLY REINFORCED CONCRETE PAVEMENT (FOR USE WITH BAR REINFORCEMENT ONLY)	301.11
	9" CONTINUOUSLY REINFORCED CONCRETE PAVEMENT (LEAVE OUT JOINT DETAIL)	301.12
PR-5	9" CONTINUOUSLY REINFORCED CONCRETE PAVEMENT 14 FOOT TRAVEL LANE	301.13
	9" CONTINUOUSLY REINFORCED CONCRETE PAVEMENT 14 FOOT TRAVEL LANE	301.14
	9" CONTINUOUSLY REINFORCED CONCRETE PAVEMENT 14 FOOT TRAVEL LANE	301.15
PR-6	10" CONTINUOUSLY REINFORCED CONCRETE PAVEMENT 14 FOOT TRAVEL LANE	301.16
	10" CONTINUOUSLY REINFORCED CONCRETE PAVEMENT 14 FOOT TRAVEL LANE	301.17
	10" CONTINUOUSLY REINFORCED CONCRETE PAVEMENT 14 FOOT TRAVEL LANE	301.18
PR-7	11" CONTINUOUSLY REINFORCED CONCRETE PAVEMENT 14 FOOT TRAVEL LANE	301.19
	11" CONTINUOUSLY REINFORCED CONCRETE PAVEMENT 14 FOOT TRAVEL LANE	301.20
	11" CONTINUOUSLY REINFORCED CONCRETE PAVEMENT 14 FOOT TRAVEL LANE	301.21
PR-8	12" CONTINUOUSLY REINFORCED CONCRETE PAVEMENT 14 FOOT TRAVEL LANE	301.22
	12" CONTINUOUSLY REINFORCED CONCRETE PAVEMENT 14 FOOT TRAVEL LANE	301.23
	12" CONTINUOUSLY REINFORCED CONCRETE PAVEMENT 14 FOOT TRAVEL LANE	301.24
PR-9	13" CONTINUOUSLY REINFORCED CONCRETE PAVEMENT 14 FOOT TRAVEL LANE	301.25
	13" CONTINUOUSLY REINFORCED CONCRETE PAVEMENT 14 FOOT TRAVEL LANE	301.26
	13" CONTINUOUSLY REINFORCED CONCRETE PAVEMENT 14 FOOT TRAVEL LANE	301.27
XJ-1	BRIDGE APPROACH EXPANSION JOINT (FOR WIDENING OR MAINTENANCE OF EXISTING XJ-1 ONLY)	302.01
	BRIDGE APPROACH EXPANSION JOINT (INSTALLATION CRITERIA)	302.02
WP-1	<del>METHOD OF WIDENING BRIDGE APPROACH PAVEMENT</del>	THIS STANDARD IS VOID <del>303.01</del>
WP-2	PAVEMENT WIDENING	303.02
RS-1	CONTINUOUS SHOULDER RUMBLE STRIPS	304.01
RS-3	CENTERLINE RUMBLE STRIPS	304.02
RS-4	CONTINUOUS SHOULDER RUMBLE STRIPES	304.03
RS-5	INTERMITTENT SHOULDER RUMBLE STRIPS	304.04
ACOT-1	ASPHALT CONCRETE OVERLAY TRANSITIONS (REPLACES THE STANDARD TPT-1 TRANSVERSE PAVEMENT TIE-IN)	305.01

## INDEX OF SHEETS SECTION 300-PAVEMENT ITEMS

VIRGINIA DEPARTMENT OF TRANSPORTATION

**VDOT**


ROAD AND BRIDGE STANDARDS

REVISION DATE

SHEET 1 OF 1

7/13


300.01

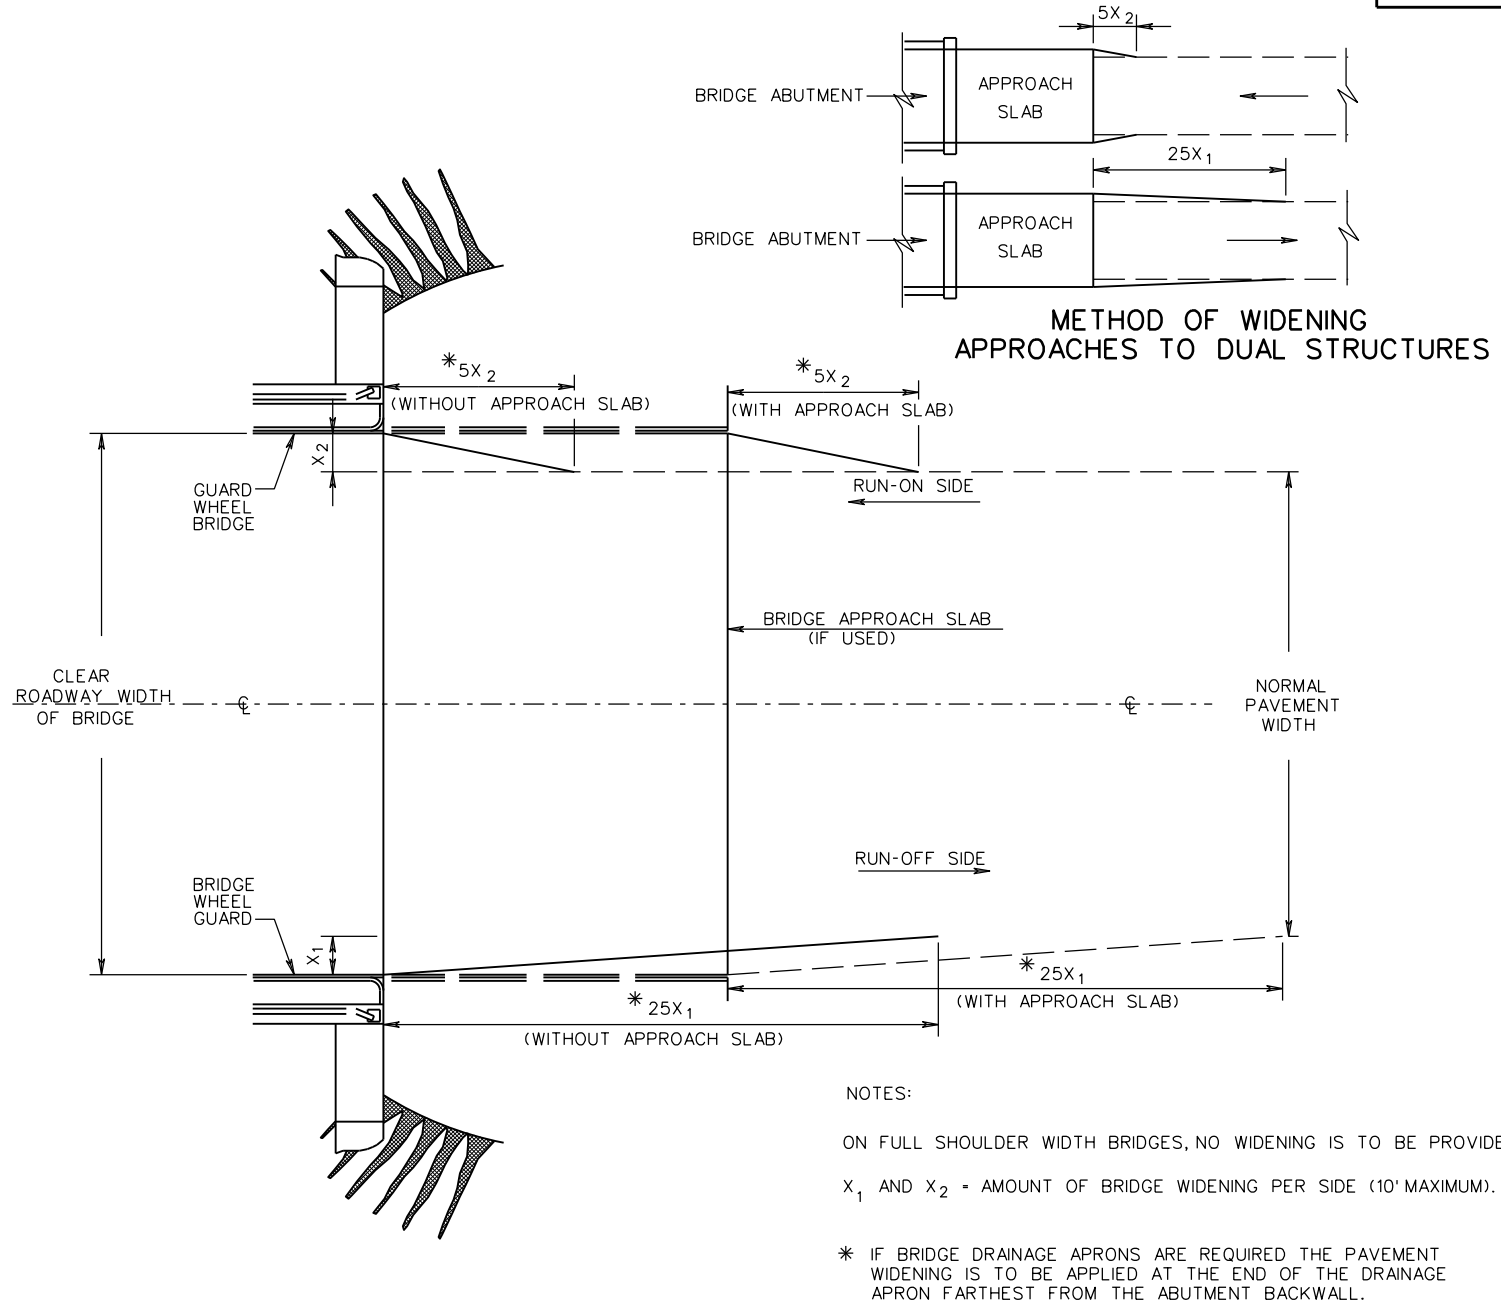


THIS DRAWING WAS VOID WITH THE JULY 2013 R&B STANDARDS REVISION

SPECIFICATION REFERENCE	<b>METHOD OF WIDENING BRIDGE APPROACH PAVEMENT</b>	<b>VDOT</b> ROAD AND BRIDGE STANDARDS
NONE	<b>VOID</b> VIRGINIA DEPARTMENT OF TRANSPORTATION	REVISION DATE 7/12
		SHEET 1 OF 1 303.01

← DIRECTION OF TRAFFIC

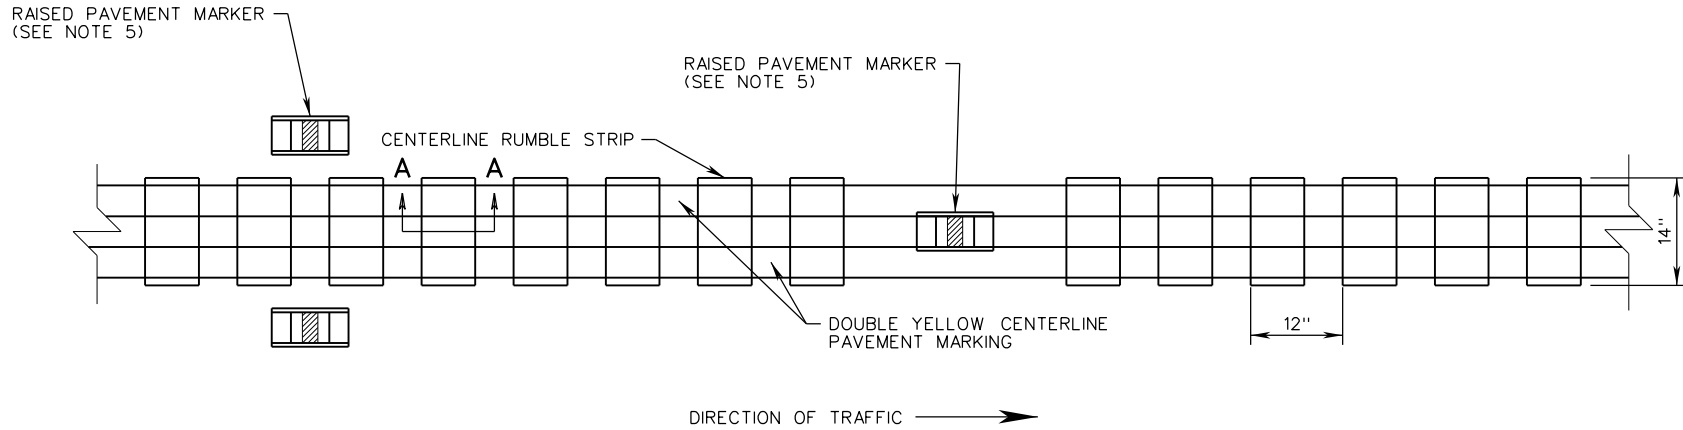

PLAN VIEW

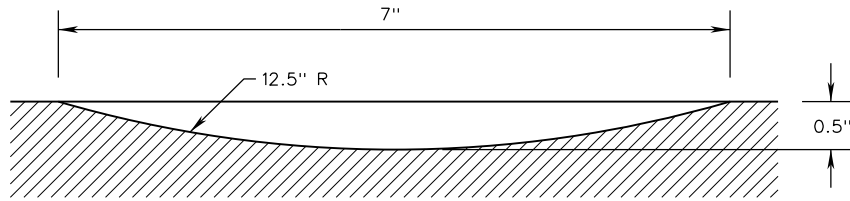

SECTION A-A

NOTES

1. CENTERLINE RUMBLE STRIPS SHALL NOT BE INSTALLED WITHIN THE LIMITS OF BRIDGES.
2. CENTERLINE RUMBLE STRIPS SHALL NOT BE INSTALLED ON SUBDIVISION STREETS OR IN NARROW UNMARKED ROAD SECTIONS WITHOUT PAVEMENT MARKINGS.
3. CENTERLINE RUMBLE STRIPS SHALL NOT BE INSTALLED WITHIN THE LIMITS OF CENTER TWO-WAY TURN LANES.
4. CENTERLINE RUMBLE STRIPS SHALL NOT BE INSTALLED IN PASSING ZONES EXCEPT AS DIRECTED BY THE TRAFFIC ENGINEER. THE DEPTH OF CENTERLINE RUMBLE STRIPS IN PASSING ZONES SHALL BE  $\frac{3}{8}$ ".
5. USE OF RAISED PAVEMENT MARKERS IS OPTIONAL. SEE STANDARD PM-9 FOR DETAILS ON RAISED PAVEMENT MARKER PLACEMENT. WHEN NECESSARY TO ACCOMMODATE THE PM-9 STANDARD TWO GROOVES SHALL BE OMITTED EVERY 40' TO ALLOW FOR A CENTERLINE RAISED PAVEMENT MARKER.
6. WHERE A LEFT-TURN LANE IS MARKED, THE CONTINUOUS CENTERLINE RUMBLE STRIPS SHALL FOLLOW THE DOUBLE YELLOW MARKINGS OF THE OPPOSING LANES AND SHALL STOP 50 FEET FROM THE EDGE OF THE INTERSECTING DRIVEWAY OR ROADWAY.
7. FOLLOWING CUTTING AND CLEANING DEPRESSIONS OF WASTE MATERIAL, THE ENTIRE RUMBLE STRIP AREA SHALL BE COATED WITH LIQUID ASPHALT COATING (EMULSION) USING A PRESSURE DISTRIBUTOR AT AN APPROXIMATE RATE OF 0.1 GALLON PER SQUARE YARD. OVERSPRAY SHALL NOT EXTEND MORE THAN 2 INCHES BEYOND THE WIDTH OF CUT AND/OR SHALL NOT COME IN CONTACT WITH PAVEMENT MARKINGS.
8. PAVEMENT MARKINGS SHALL BE PLACED AS DIRECTED BY THE ENGINEER.



ROAD AND BRIDGE STANDARDS

CENTERLINE RUMBLE STRIPS

SPECIFICATION REFERENCE

SHEET 1 OF 1


REVISION DATE

310  
315

304.02


7/13

VIRGINIA DEPARTMENT OF TRANSPORTATION

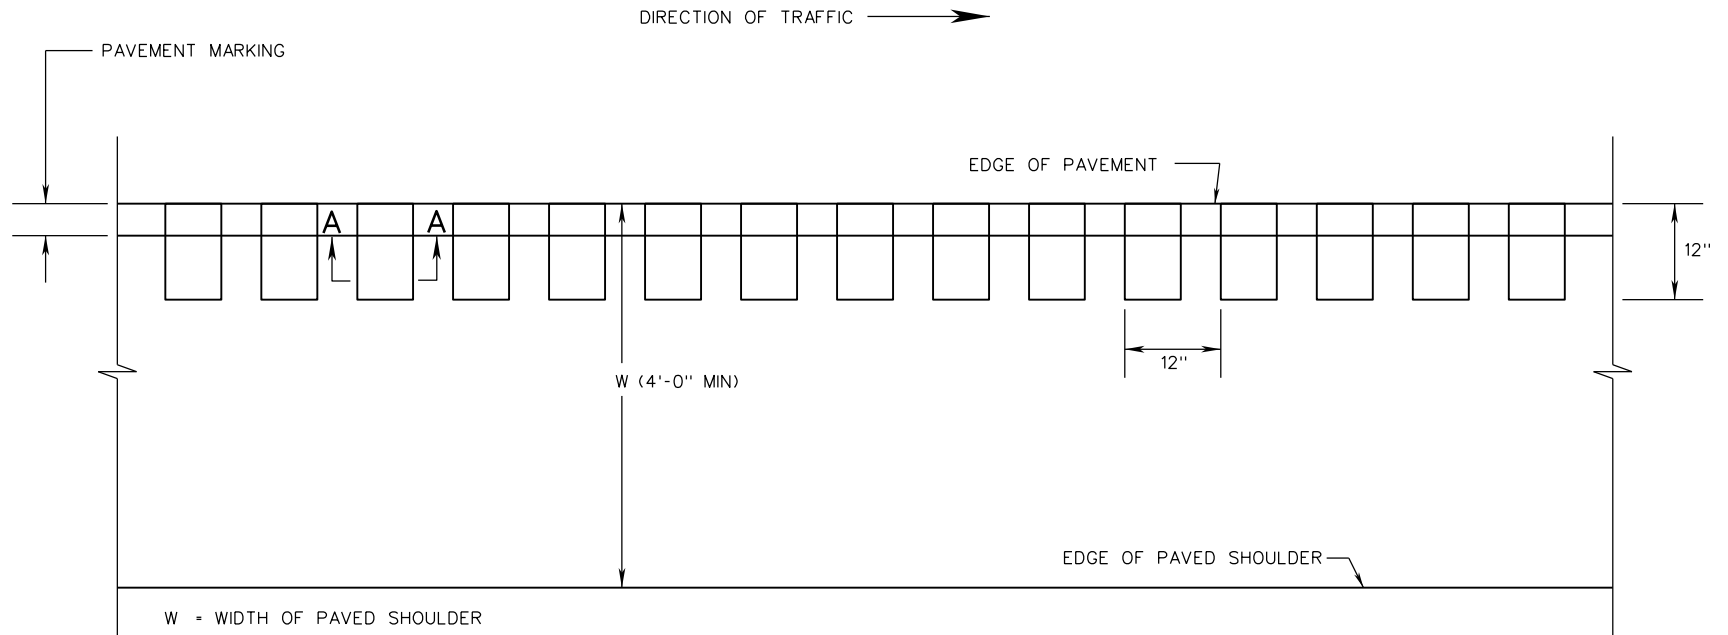

W = WIDTH OF PAVED SHOULDER

PLAN VIEW

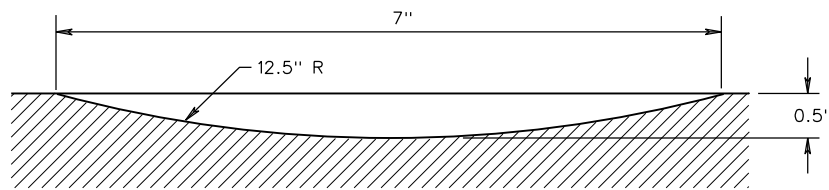

SECTION A-A

NOTES

1. RUMBLE STRIPES SHALL BE PLACED CONTINUOUSLY AS DIRECTED BY THE ENGINEER.
2. RUMBLE STRIPES SHALL NOT BE PLACED WITHIN LIMITS OF BRIDGE DRAINAGE APRONS OR SPECIAL DESIGN SHOULDER SLOT INLETS.
3. RUMBLE STRIPES SHALL BE PLACED ON MAINLINE SHOULDERS ONLY.
4. FOLLOWING CUTTING AND CLEANING DEPRESSIONS OF WASTE MATERIAL, THE ENTIRE RUMBLE STRIP AREA SHALL BE COATED WITH LIQUID ASPHALT COATING (EMULSION) USING A PRESSURE DISTRIBUTOR AT AN APPROXIMATE RATE OF 0.1 GALLON PER SQUARE YARD. OVERSPRAY SHALL NOT EXTEND MORE THAN 2 INCHES BEYOND THE WIDTH OF CUT AND/OR SHALL NOT COME IN CONTACT WITH PAVEMENT MARKINGS.
5. RUMBLE STRIPES SHALL NOT BE PLACED WITHIN 50 FEET OF ANY INTERSECTION, TURN LANE, ACCELERATION/DECELERATION LANE OR GORE AREA.
6. PAVEMENT MARKINGS SHALL BE PLACED AS DIRECTED BY THE ENGINEER.

SPECIFICATION REFERENCE

310  
315

A COPY OF THE ORIGINAL SEALED AND SIGNED STANDARD DRAWING IS ON FILE IN THE CENTRAL OFFICE

CONTINUOUS SHOULDER RUMBLE STRIPES

VIRGINIA DEPARTMENT OF TRANSPORTATION

VDOT





ROAD AND BRIDGE STANDARDS

REVISION DATE

SHEET 1 OF 1

7/13

304.03

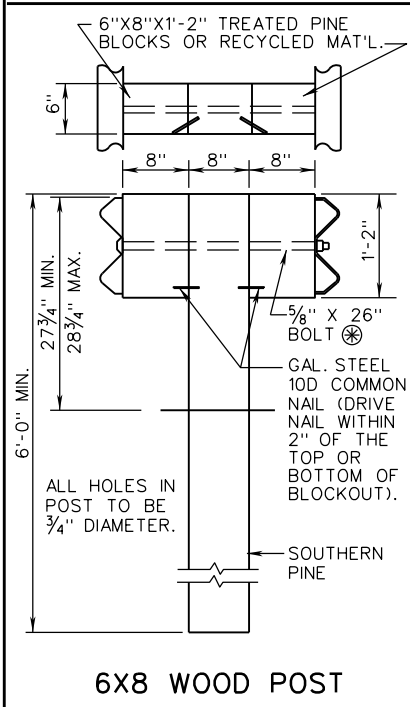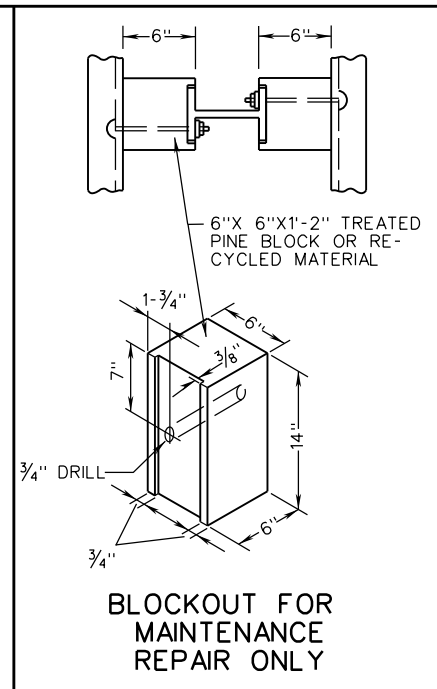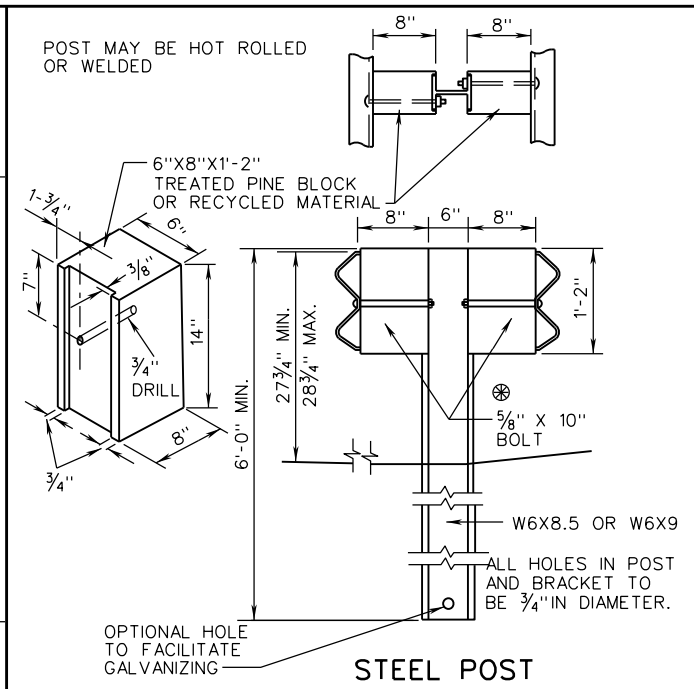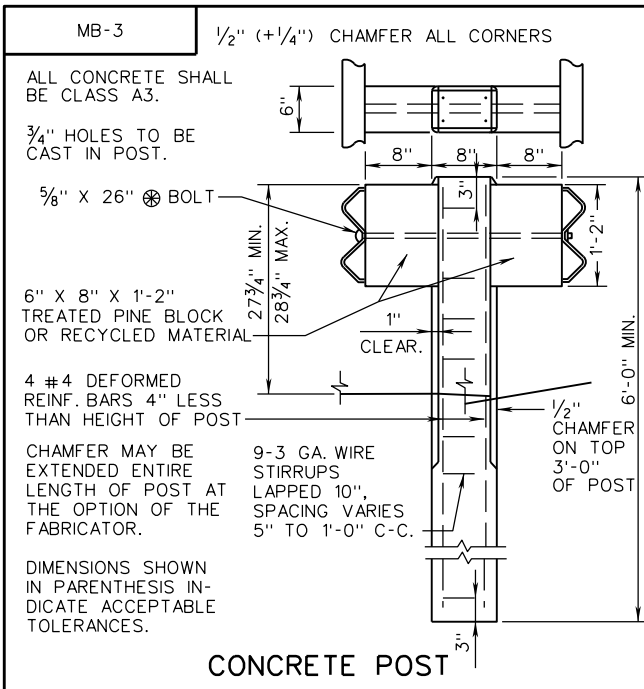

NOTES:

STANDARD MB-3 POST SPACING IS 6'-3".

FOR DETAILS OF RAIL ELEMENT, RAIL SPLICE JOINT, W BEAM BACK UP PLATE, AND ASSOCIATED HARDWARE SEE SHEET NO. 501.01.

ALTERNATE TYPE POSTS AND BLOCKOUTS MAY BE INTERCHANGED ON ANY ONE PROJECT WITH THE RESTRICTION THAT THE SAME TYPE OF POST AND BLOCKOUT MUST BE USED IN ANY SINGLE RUN OF MEDIAN BARRIER.


ALL BOLTS, NUTS, WASHERS, STEEL POSTS, BENT PLATE POST, AND BLOCKOUTS ARE TO BE GALVANIZED.

THE GUARDRAIL AND MEDIAN BARRIER COMPONENTS DEPICTED IN A.R.T.B.A. TECHNICAL BULLETIN NUMBER 268B MAY BE SUBSTITUTED IF INTERCHANGEABLE WITH THE STANDARDS FOR GUARDRAIL (GR) OR MEDIAN BARRIER (MB) AND APPROVED BY THE ENGINEER.

⊗ STANDARD WASHERS ARE TO BE USED ON LAST 50' OF RUN OFF END ONLY.

DESIGN SPEED	FLARE RATES		
	INSIDE SHY LINE	BEYOND SHY LINE	
MPH	SHY LINE LS	FLARE RATE	FLARE RATE
70	9'	30:1	15:1 *
60	8'	26:1	14:1 *
50	6.5'	21:1	11:1 *
40	5'	16:1	8:1 *
30	4'	13:1	7:1 *

\* SUGGESTED MAXIMUM FLARE RATE FOR SEMI-RIGID BARRIER SYSTEMS.

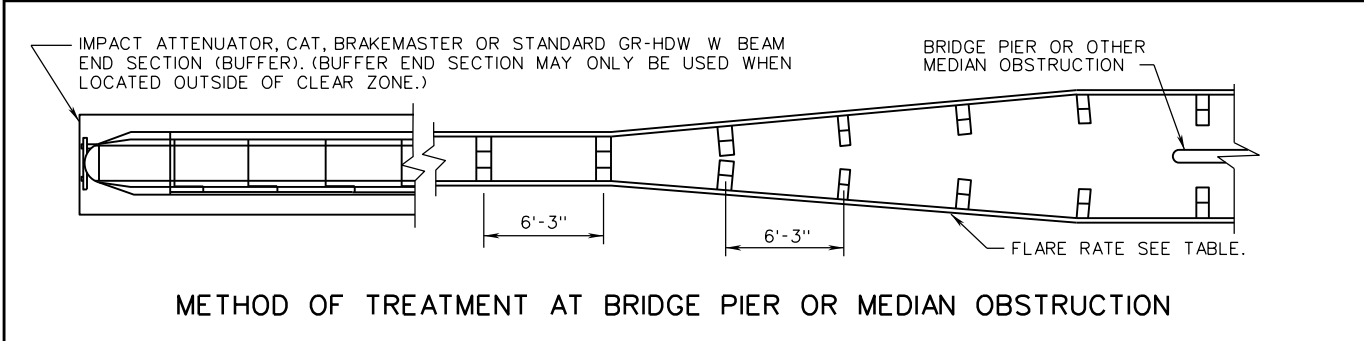





FE-W1,W2		CORNER BRACE	LINE BRACE	LINE BRACE AT END LOCATION
WOOD POST	<p>PAY LINES (EXCLUSIVE OF FABRIC) 3/8"X4" GALV. STEEL DOWEL (EACH END ALL HORIZ. BRACES)</p> <p>8'-0" 8'-0" 6"X6" CORNER POST</p>	<p>6" - FE-W1 12" - FE-W2</p> <p>6"X6" 6"X6"</p> <p>#9 WIRE TWISTED MIN. 4" BRACE</p> <p>8'-0" BRACE POST</p> <p>PAY LINES (EXCLUSIVE OF FABRIC)</p>	<p>THE BRACE WIRE TO BE PLACED AROUND POSTS WITH ONE WIRE ON EACH SIDE OF BRACE. WIRE TO BE DRAWN TAUT BY TWISTING BETWEEN BRACE AND EACH POST. THIS APPLIES TO ALL BRACE WIRES.</p> <p>DIAGONAL 4" BRACES TO BE PLACED IN DIRECTION OF PULL. POST TO BE NOTCHED FOR DIAGONAL 4" BRACES. ALL 4" DIAGONAL BRACES TO HAVE TWO GALVANIZED 12D NAILS EACH END.</p> <p>4 POINT BARBED WIRE</p> <p>4"X4" 6"X6"</p> <p>6" 5'-0" 3" 3" 2'-6" 12'-0" TYPICAL SPACING ALL LINE POSTS 8'-0" PAY LINES (EXCLUSIVE OF FABRIC)</p> <p>GROUND LINE LINE POST</p>	
	<p>* L2 1/2 X 2 1/2 X 1/4 POST WITH 2 X 2 X 3/8 X 7'-0" BRACES OR 2 1/2" O.D. POST @ 3.65 ± 5% LBS./FT. WITH 1 3/8" O.D. BRACES @ 2.2 ± 5% LBS./FT.</p> <p>12'-0" 6'-0" 6'-0" 12'-0" 3'-0" CORNER POST CONCRETE FOOTING</p>	<p>IF NOT OTHERWISE NOTED DIMENSIONS AND DESCRIPTIONS SHOWN ON ONE DRAWING APPLY TO OTHER DETAILS WITH THE SAME POST TYPE.</p> <p>6" FE-W1 12" FE-W2</p> <p>6" 3" 1'-6" 5'-0"</p> <p>GROUND LINE 6'-0" 6'-0" 12" STRETCHER POST</p> <p>12"X12"X12" CONCRETE BLOCK</p>	<p>4 POINT BARBED WIRE</p> <p>12"X12"X12" CONCRETE BLOCK 12'-0" C-C (TYPICAL SPACING BETWEEN ALL LINE POSTS)</p> <p>5'-0" 3'-0" 2'-6" 12'-0" TYPICAL SPACING ALL LINE POSTS</p> <p>LINE POST (SEE DETAIL BELOW)</p>	
<p><b>NOTES:</b></p> <p>SEE GENERAL NOTES-FENCING FOR ADDITIONAL DETAILS AND INSTRUCTIONS.</p> <p>LINE POSTS ARE TO BE OF THE TYPES SHOWN OR EQUIVALENT MEETING THE APPROVAL OF THE ENGINEER.</p> <p>ALL POSTS ARE TO HAVE A MINIMUM WEIGHT OF 1.25 LBS./FT.</p> <p>A MINIMUM OF FIVE CLAMPS FOR ATTACHING FABRIC TO POST ARE TO BE INCLUDED IN COST OF EACH LINE POST.</p> <p>FLANGED FLANGE TYPE "U" TYPE "T"</p> <p>METAL LINE POST</p>	<p>FOR USE IN LIEU OF SETTING POSTS IN CONCRETE. DEVICES SHOWN ARE REPRESENTATIONAL ONLY. SEE GENERAL NOTES.</p> <p>ALTERNATE ANCHOR DEVICES</p>	<p>L2X2X3/8 TO BE CUT TO FIT AROUND L2 1/2 X 2 1/2 X 1/4 STRETCHER POST.</p> <p>L2 1/2 X 2 1/2 X 1/4, 2" LONG BRACKET BOLTED TO STRETCHER POST</p> <p>ALTERNATE</p> <p>METHOD OF ATTACHING ANGLE BRACES TO STRETCHER POSTS</p>		



SPAN STRUCTURE

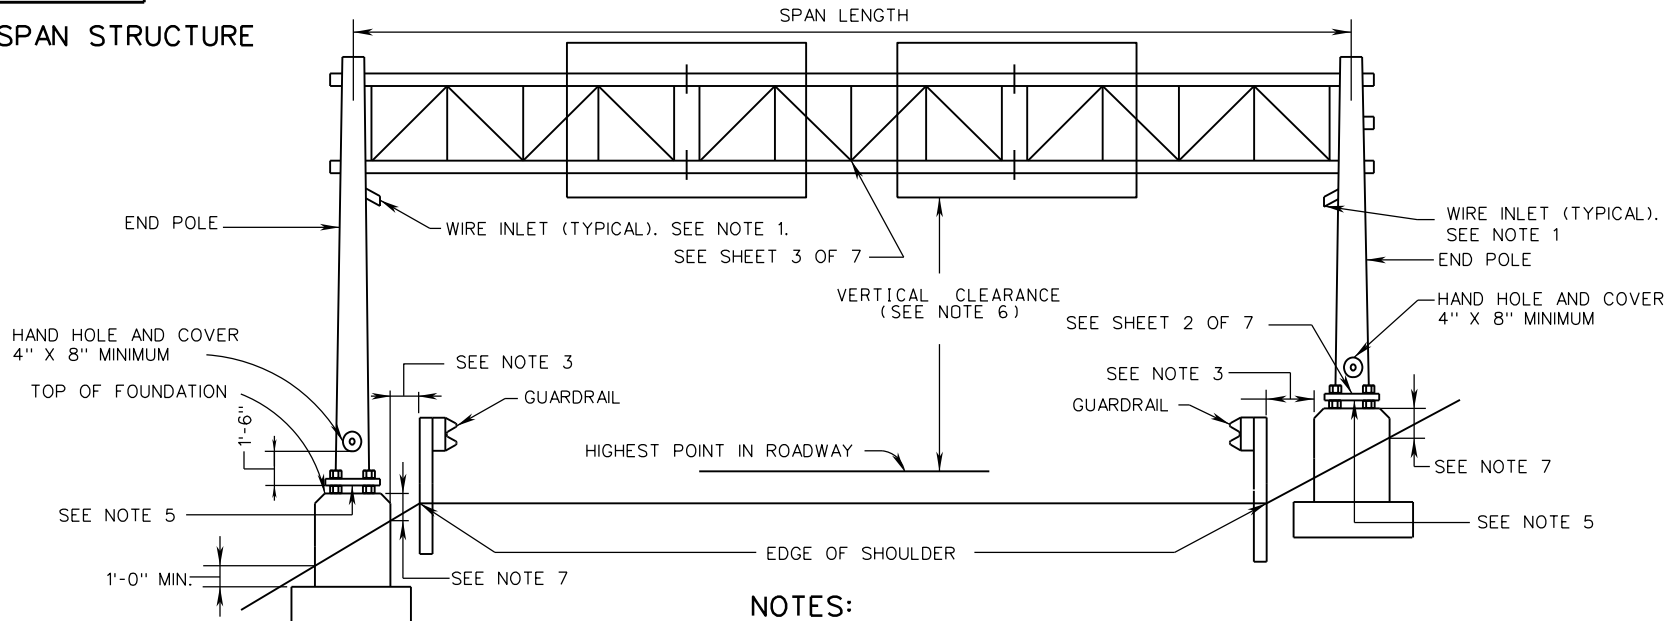

CANTILEVER STRUCTURE

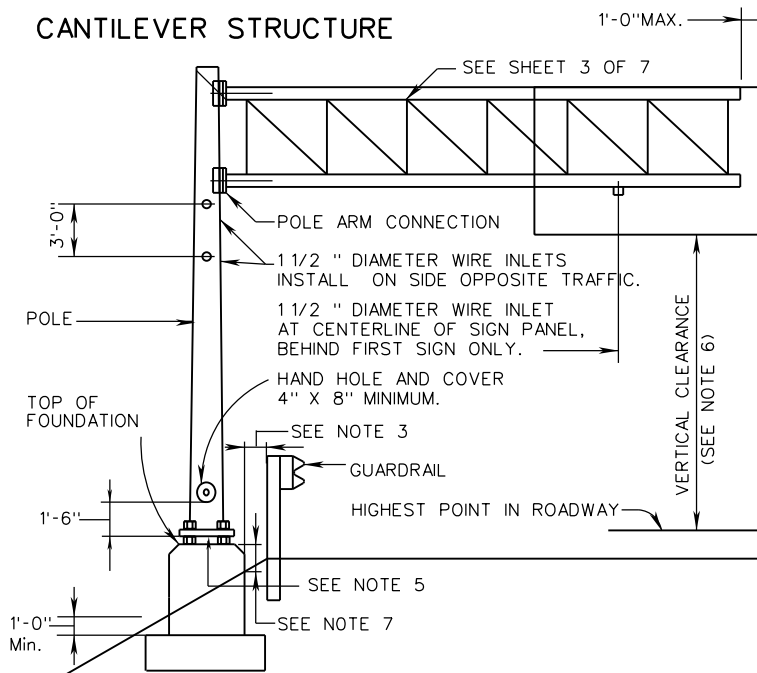

NOTES:

1. 1 1/2" DIAMETER WIRE INLETS SHALL BE PROVIDED AT THE FOLLOWING LOCATIONS:
  - A. ON SPAN STRUCTURES ON THE FRONT LEG OF END POLE 12" BELOW BOTTOM CHORD.
  - B. ON CANTILEVER STRUCTURES ON POLE 12" BELOW BOTTOM CHORD.
  - C. ON SPAN STRUCTURES BELOW BOTTOM CHORD AT CENTERLINE BEHIND FIRST SIGN PANEL FROM EACH END POLE.
  - D. ON CANTILEVER STRUCTURES BELOW BOTTOM CHORD AT CENTERLINE BEHIND FIRST SIGN PANEL FROM POLE.
2. ALL UNUSED WIRE INLETS SHALL BE CAPPED WATER TIGHT.
3. DISTANCE SHALL BE NO LESS THAN THE MINIMUM INDICATED IN GUARDRAIL STANDARDS.
4. NO MORTAR, GROUT, OR CONCRETE SHALL BE PLACED BETWEEN BOTTOM OF BASE PLATE AND TOP OF PEDESTAL.
5. THE MAXIMUM SPACE BETWEEN THE BOTTOM OF THE BASE PLATE AND THE TOP OF THE FOUNDATION SHALL BE NO MORE THAN THE DIAMETER OF THE ANCHOR BOLT PLUS ONE INCH.
6. VERTICAL CLEARANCE FOR OVERHEAD SIGN STRUCTURES SHALL BE NO LESS THAN 19 FEET 0 INCH AND NO MORE THAN 21 FEET 0 INCH FROM THE BOTTOM OF THE LOWEST MOUNTED SIGN PANEL TO THE HIGHEST POINT OF THE ROADWAY, UNLESS OTHERWISE SPECIFIED ON THE PLANS. LUMINAIRE ASSEMBLIES SHALL HAVE A VERTICAL CLEARANCE OF NO LESS THAN 17 FEET 6 INCHES FROM THE BOTTOM OF THE ASSEMBLY TO THE HIGHEST POINT OF THE ROADWAY.
7. TOP OF FOUNDATIONS SHALL BE 2'-0" MINIMUM ABOVE FINISHED GRADE. FOR FOUNDATIONS ADJACENT OR WITHIN A SIDEWALK, TOP OF FOUNDATIONS SHALL BE A MINIMUM OF 3" ABOVE FINISHED GRADE.
8. FOUNDATIONS SHALL NOT BE LOCATED IN A DRAINAGE DITCH.



ROAD AND BRIDGE STANDARDS

A COPY OF THE ORIGINAL SEALED AND SIGNED STANDARD DRAWING IS ON FILE IN THE CENTRAL OFFICE

OVERHEAD SIGN STRUCTURE

SPECIFICATION REFERENCE

SHEET 1 OF 7

REVISION DATE

TYPICAL DETAILS


1324.10

7/13


VIRGINIA DEPARTMENT OF TRANSPORTATION

700

TYPICAL SIGN FOOTING DETAIL WITH CONDUIT

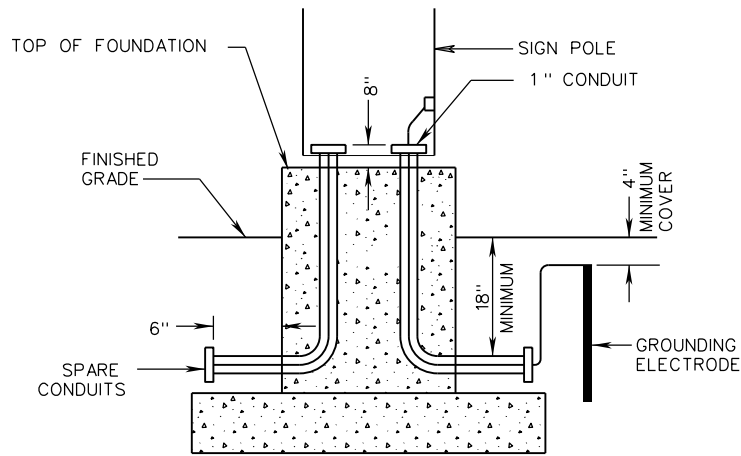

LOCATION OF FUTURE USE CONDUITS FOR DOUBLE END POLE STRUCTURES

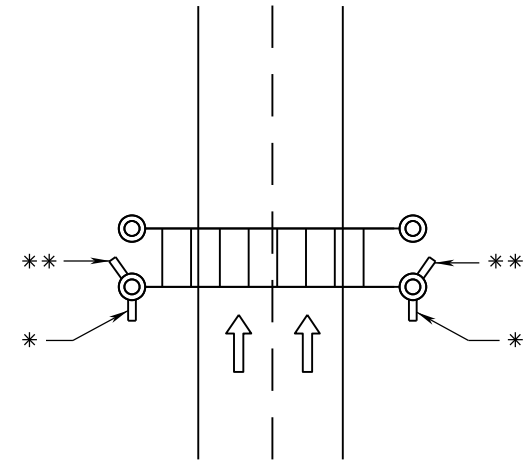

\* FUTURE USE CONDUITS PLACED PARALLEL TO THE ROADWAY

\*\* FUTURE USE CONDUITS PLACED AT AN ANGLE TO MISS THE BACK FOUNDATION OR ANCHOR BOLTS IN A SPREAD FOOTING FOUNDATION.

**NOTES:**

THE TYPE, SIZE, NUMBER AND ORIENTATION OF CONDUITS ENTERING AND EXITING FOOTINGS MAY VARY PER SIGN LOCATION.

IN ADDITION TO THE CONDUITS SPECIFIED ON THE PLANS, ONE - 1" CONDUIT REQUIRED FOR GROUND WIRE AND TWO - 2" PVC HEAVY WALL CONDUITS REQUIRED FOR FUTURE USE. FUTURE USE CONDUITS SHALL BE STUBBED OUT AND CAPPED. FUTURE USE CONDUITS SHALL BE ORIENTED TO RUN PARALLEL TO THE ROADWAY. FOR LOCATION OF FUTURE USE CONDUITS IN FOUNDATIONS FOR DOUBLE END POLE STRUCTURES, SEE DRAWING AT RIGHT.

EACH FOUNDATION SHALL BE PERMANENTLY MARKED TO INDICATE ALL SIDES FROM WHICH CONDUITS PASS. THIS MARK SHALL BE MADE WITH A TROWEL WHEN FINISHING THE CONCRETE AND SHALL BE 1/4" DEEP AND 4" TO 6" LONG. LOCATIONS OF EMPTY CONDUITS SHALL HAVE AN ADDITIONAL 2" LONG MARK MADE PERPENDICULAR TO AND CENTERED ON THIS MARK.

FOUNDATIONS ABOVE FINISHED GRADE SHALL BE CHAMFERED 3/4" ON ALL EDGES.

GROUNDING BUSHINGS SHALL BE INSTALLED ON EACH END OF METAL CONDUITS.

BELL ENDS SHALL BE INSTALLED ON EACH END OF PVC CONDUITS.

BELL ENDS & BUSHINGS OF EMPTY CONDUITS SHALL BE PLUGGED TO PREVENT MOISTURE AND RODENT ENTRY.

VOIDS REMAINING AFTER CONDUCTORS EXIT OR ENTER BELL ENDS OR BUSHINGS OF CONDUITS SHALL BE SEALED WITH SILICONE TO PREVENT MOISTURE AND RODENT ENTRY.

NO MORTAR, GROUT, OR CONCRETE SHALL BE PLACED BETWEEN BOTTOM OF BASE PLATE AND TOP OF FOUNDATION.

SPECIFICATION REFERENCE	700	A COPY OF THE ORIGINAL SEALED AND SIGNED STANDARD DRAWING IS ON FILE IN THE CENTRAL OFFICE	<b>OVERHEAD SIGN STRUCTURE</b>	
			<b>FOUNDATION DETAILS</b>	
VIRGINIA DEPARTMENT OF TRANSPORTATION			<b>VDOT</b>	ROAD AND BRIDGE STANDARDS
			REVISION DATE	SHEET 4 OF 7
			7/13	1324.13